Electrical Trade Scope of Work

SECTION 1: General Requirements INCLUDED:

- 1. Access panels in walls, ceilings and floors, where required for electrical requirements -- to be supplied to respective
- trade for installation, e.g. to ceiling contractor, etc. 2. All power distribution and equipment within the property
- 3. All electrical work covered by the Canadian & Ontario
- Electrical Code
- 4. Electrical connection only to appliances
- 6. Clean up -- for electrical trade only.
- General clean up as per OCA quidelines
- 7. Consumables -- (screws, bolts, hangers, straps, seismic restraint, (etc) for electrical equipment and systems
- 8. Drainage connections for conduit systems (excluding drain
- 9. Hoisting for materials and equipment.
- 10. Electrical Safety Authority Inspection
- 11. Licenses -- Masters & Contractor licensing
- 12. Permits -- as required for electrical work only. 13. Poly and/or plastic vapour barrier for electrical when
- required.
- 14. Power supplies
- 15. Power wiring -- for equipment in mechanical document shown in the tender documents, shall include without limiting the scope, all necessary wiring materials and connections
- 16. Raceways 17. Relays
- 18. Scaffolding for electrical work.
- 19. Shop drawings -- where required.
- 20. Sleeves, through poured-in-place concrete and masonry where required for electrical conduit, wire or equipment.
- 21. Supports for electrical systems only
- 22. Switches -- all types of electrical switches for systems in the electrical document.
- 23. Timers
- 24. Wire-branch circuits, feeders for systems in the tender
- 25. Specification grade wiring devices and plates.
- 26. Design, Supply and installation of vibration isolation and
- seismic restraint for electrical systems. 27. Fire stopping for electrical services only
- 28. Identification of electrical systems as indicated in the tender documents and as mandated by the Ontario electrical code
- 29. Electrical systems commissioning, as built drawings and operation and maintenance documents as specified

ELECTRICAL LEGEND

- DUPLEX RECEPTACLE DUPLEX RECEPTACLE
- GFI RECEPTACLE
- VOICE/DATA OUTLET C/W 3/4" CONDUIT TO CEILING SPACE ONE GANG SWITCH
- 3 WAY SWITCH
- COUNT DOWN TIMER . MANUAL SWITCH 'ON' AUTOMATIC
- INCANDESCENT/HID LIGHT WALL MOUNTED LIGHT
- N.L NIGHT LIGHTING
- RUNNING MAN TYPE
- UNIT MUST RUN ALL REMOTE HEADS & EXIT SIGNS CONNECTED TO IT FOR A MINIMUM OF 30 MINUTES
- EMERGENCY REMOTE LIGHT WITH 2-6W LED HEADS
- ///// PANEL BOARD
- EXHAUST FAN
- FORCE FAN HEATER

CAPACITY REFER TO DRAWING M-3

- 56" 3-BLADE INDUSTRIAL CEILING FAN, WHITE C/W MULTI SPEED WALL CONTROL EMERGENCY PUSH-BUTTON.
- RESET
- JUNCTION BOX
- 50A, 220V OUTLET FOR WELDING STATION

SWITCH 'OFF' LIGHT FIXTURE

EXIT SIGN, LED, EXTRUDED ALUMINUM

EMERGENCY BATTERY UNIT C/W 2-6W LED HEADS.

- MUSHROOM HEAD (70 mm DIAMETER) 'TWIST & PULL TO
- EMERGENCY CALL SYSTEM
- OCCUPANCY SENSOR, EQUAL TO: LEVITON # OSFHS-ITW, 1500 VA, 3600 SQ.FT COVERAGE

GENERAL INSTRUCTIONS

CONDITIONS OF CONTRACT

- THE OWNERS INSTRUCTIONS TO BIDDERS AND THE GENERAL CONDITIONS OF THE DESIGNERS SPECIFICATIONS ARE AN INTEGRAL PART OF THIS CONTRACT AND SHALL BE READ IN CONJUNCTION HEREWITH. THESE INSTRUCTIONS TO BIDDERS AND GENERAL CONDITIONS SHALL BE FULLY BINDING ON THE GENERAL CONTRACTOR AND HIS SUB-CONTRACTORS TO THE FULL SATISFACTION OF THE DESIGNER, ENGINEER AND OWNER.
- THE RESPONSIBILITY AND SCOPE OF EACH SUB-TRADE RESTS SOLELY WITH THE CONTRACTOR. EXTRAS WILL NOT BE CONSIDERED BASED ON THE GROUNDS OF DIFFERENCE IN THE INTERPRETATION OF SPECIFICATIONS AND DRAWINGS AS TO WHICH TRADE INVOLVED SHALL PROVIDE CERTAIN SPECIALTIES OR MATERIALS.
- IT IS A CONDITION OF THIS CONTRACT, THAT THE CONTRACTOR WILL, IN THE PERFORMANCE OF THE SERVICES FOR THE OWNER AS DESCRIBED IN THIS CONTRACT. PERFORM WORK IN ACCORDANCE WITH ONTARIO BUILDING CODE LATEST EDITION, THE ONTARIO HYDRO ELECTRICAL SAFETY CODE, THE SEWAGE SYSTEMS ENVIRONMENTAL PROTECTION ACT ONTARIO INCLUDING DISPOSAL OF WASTE, WORKPLACE HAZARDOUS MATERIAL INFORMATION SYSTEM (WHMIS), O.REG 644/88, THE ONTARIO GAS UTILIZATION CODE, AND ANY OTHER CODE OF PROVINCIAL OR LOCAL APPLICATION, INCLUDING HOURS OF WORK, RATES OF PAY, JOB SAFETY AND ALL OTHER MATTERS IN WHICH THE MUNICIPAL OR FEDERAL AUTHORITIES HAVE JURISDICTION, PROVIDED THAT IN ANY CASE OF CONFLICT OR DISCREPANCY, THE MORE
- COMPLY WITH STANDARD FOR BUILDING CONSTRUCTION OPERATIONS, ISSUED BY THE ONTARIO FIRE MARSHAL'S OFFICE AND ALL APPLIANCE FIRE SAFETY CODES, LAWS, AND REGULATIONS.
- IT IS INCUMBENT UPON THE CONTRACTOR TO INFORM ITSELF OF ANY SUCH LEGISLATION AND THE CONTRACTOR AGREES THAT IN THE EVENT OF NON-COMPLIANCE WITH THIS LEGISLATION. IT WILL INDEMNIFY AND HOLD HARMLESS THE OWNER FROM ANY COSTS AND DAMAGES RESULTING FROM SUCH NON-COMPLIANCE.
- ALL WORK SHALL BE CARRIED OUT IN ACCORDANCE WITH STANDARDS OF GOOD PRACTICE AND MEET OR EXCEED REQUIREMENTS OF CONTRACT DOCUMENTS, SPECIFIED STANDARDS, CODES AND REFERENCED DOCUMENTS DESCRIBED IN THESE INSTRUCTIONS

XAMINATION OF WORK

THIS PROJECT INVOLVES CONSTRUCTION OF A NEW BUILDING. THEREFORE EXAMINE THE SITE AND LOCAL CONDITIONS TO DETERMINE THE DIFFICULTIES IN CARRYING OUT THE WORK INDICATED AND SPECIFIED PRIOR TO SUBMITTING FINAL

<u>INTENT</u>

IT IS THE INTENT OF THIS SPECIFICATION AND DRAWINGS TO PROVIDE FOR A COMPLETE AND FULLY OPERATING SYSTEM IN COMPLETE ACCORD WITH ALL APPLICABLE CODES. THESE DOCUMENTS MAY NOT SHOW OR DESCRIBE EACH AND EVERY ITEM REQUIRED FOR THE COMPLETE INSTALLATION; THEREFORE, THE CONTRACTOR SHALL MAKE PROVISIONS FOR ALL LABOUR, MATERIAL AND EQUIPMENT DEEMED NECESSARY TO COMPLETE THE WORK INDICATED OR REASONABLY IMPLIED ON ALL DRAWINGS.

THIS CONTRACTOR SHALL ASSUME FULL RESPONSIBILITY FOR LAYING OUT HIS WORK AND FOR ANY DAMAGE OR EXTRA COSTS CAUSED TO THE OWNER OR OTHER CONTRACTORS BY IMPROPER LOCATION OR CARRYING OUT OF HIS WORK. CARRY ALL NECESSARY INSURANCE COVERAGE.

PERMITS, CERTIFICATES, FEES, ETC.

GIVE ALL NOTICES, OBTAIN ALL PERMITS AND PAY ALL FEES SO THAT THE WORK SPECIFIED HEREIN MAY BE CARRIED OUT, EXCEPT FOR BUILDING OCCUPANCY PERMITS WHICH WILL BE OBTAINED BY THE OWNER. AT THE ENGINEER'S REQUEST, FURNISH ANY CERTIFICATES AS EVIDENCE THAT THE WORK INSTALLED CONFORMS WITH THE LAWS AND REGULATIONS OF ALL AUTHORITIES HAVING JURISDICTION.

<u>SUARANTEE</u>

THE CONTRACTOR, AS A CONDITION PRECEDENT TO FINAL PAYMENT AFTER COMPLETION OF THIS WORK, SHALL GIVE THE OWNER A WRITTEN GUARANTEE WARRANTING ALL APPARATUS FURNISHED UNDER THE CONTRACT TO REMAIN IN PERFECT SERVICEABLE CONDITION FOR A PERIOD OF ONE YEAR FROM THE DATE OF SUBSTANTIAL PERFORMANCE OF HIS WORK AS ESTABLISHED BY THE PROJECT MANAGER AND ENGINEER.

DOCUMENTS REQUIRED

- MAINTAIN AT JOB SITE A COPY OF EACH OF THE FOLLOWING DOCUMENTS:
- .2 SPECIFICATIONS
- .3 ADDENDA.
- .4 CHANGE ORDERS. .5 OTHER MODIFICATIONS TO CONTRACT.
- .6 FIELD TEST REPORTS. .7 MANUFACTURER'S INSTALLATION AND APPLICATION INSTRUCTIONS.

REVIEW OF SHOP DRAWINGS

GENERAL CONTRACTOR.

SHOP DRAWINGS MUST BE REVIEWED AND

STAMPED BY BOTH SUB-CONTRACTOR AND

REVIEW BY ENGINEER IS ONLY FOR THE

DESIGN AND DOES NOT RELIEVE THE

FOR ENSURING THAT ALL SPACES.

COORDINATION, INSTALLATION AND

CAPACITIES. SPECIFICATION

VERIFICATION OF GENERAL QUALITY AND

CONTRACTOR FROM HIS RESPONSIBILITY

CONTRACTUAL REQUIREMENTS ARE MET.

- ALL INCIDENTAL WORK REQUIRED TO COMPLETE THIS PROJECT SHALL BE THE FULL RESPONSIBILITY OF THE CONTRACTOR. WHEN ADDITIONAL WORK IS REQUESTED, A QUOTE WILL BE REQUESTED IN THE FORM OF A CONTEMPLATED CHANGE NOTICE (CCN) FROM THE CONTRACTOR. THIS QUOTE WILL BE SUBMITTED TO THE PROJECT MANAGER WITHIN THREE (3) DAYS OF THE REQUEST, TO AVOID DELAYS IN THE PERFORMANCE OF THE WORK
- NO WORK IS TO BE PERFORMED BY THE CONTRACTOR WITHOUT WRITTEN APPROVAL OF THE PROJECT MANAGER. ANY REQUEST FROM OTHERS MUST BE DIRECTED TO THE PROJECT MANAGER FOR APPROVAL.

AS-BUILT AND RECORD DRAWINGS

KEEP IN THE JOB OFFICE AN EXTRA TWO (2) SETS OF WHITE PRINTS AND SPECIFICATIONS ON WHICH ALL CHANGES AND DEVIATIONS SHALL BE RECORDED, AS THEY OCCUR, ONTO ONE (1) SET. AT COMPLETION OF THE PROJECT, TRANSFER ALL CHANGES TO THE SECOND. CLEAN SET OF "AS-BUILT" DRAWINGS AND TURN THESE OVER TO THE ENGINEER WHO WILL PROVIDE THE OWNER A CAD SET OF "RECORD" DRAWINGS.

SHOP DRAWINGS

BEFORE FABRICATION OR DELIVERY OF ANY MATERIALS OR EQUIPMENT, SUBMIT A MINIMUM OF FOUR (4) COMPLETE SET OF SHOP DRAWINGS AND DATA SHEETS COVERING ALL ITEMS OF EQUIPMENT FURNISHED AND INTENDED FOR INSTALLATION UNDER THIS CONTRACT FOR APPROVAL BY THE ENGINEER.

- TEMPORARY OR TRIAL USAGE BY THE OWNER OF ANY MACHINERY, APPARATUS, EQUIPMENT OR ANY OTHER WORK OR MATERIALS SUPPLIED UNDER THE CONTRACT BEFORE FINAL WRITTEN ACCEPTANCE BY THE ENGINEER IS NOT TO BE CONSTRUED AS EVIDENCE OF THE ACCEPTANCE OF SAME BY THE OWNER. THE OWNER SHALL HAVE THE PRIVILEGE OF SUCH TEMPORARY AND TRIAL USAGE AS SOON AS THIS CONTRACTOR CLAIMS THAT SAID WORK IS COMPLETED. ANY DAMAGE CAUSED BY DEFECTIVE MATERIAL OR WORKMANSHIP THROUGH TEMPORARY OR TRIAL USAGE BY THE OWNER SHALL BE THE RESPONSIBILITY OF
- ANY PERMANENT EQUIPMENT USED TEMPORARILY FOR TEMPORARY HEAT OR OTHERWISE WILL BE COMPLETELY REPAIRED, REPLACED, AND CLEANED TO THE FULL SATISFACTION OF THE OWNER.

EXPLOSIVES ACTUATED FASTENING DEVICES

DO NOT EMPLOY POWER GUNS USING EXPLOSIVES, UNLESS EXPRESSLY PERMITTED BY THE PROJECT MANAGER; COMPLY WITH REQUIREMENTS OF CSA Z-166 (SAFETY CODE FOR EXPLOSIVE ACTUATED TOOLS).

THE SECURITY OF THE CONTRACTOR'S EQUIPMENT AND MATERIALS SHALL BE HIS RESPONSIBILITY. CONTRACTOR SHALL LIAISE WITH THE BUILDING OPERATOR AS NECESSARY.

PARKING, ELEVATORS AND REFUSE BINS

ALL TO BE CO-ORDINATED THROUGH ON-SITE BUILDING SUPERINTENDENT.

PROVIDE WARNING SIGNS IN LOCATIONS WHERE RENOVATIONS AND ALTERATION WORK IS ADJACENT TO AREAS AFFECTING THE PUBLIC.

QUIPMENT AND SITE CLEANLINESS

- DUCTS AND EQUIPMENT SHALL BE THOROUGHLY CLEANED OF DIRT, CUTTINGS AND OTHER FOREIGN SUBSTANCES. DISCONNECT, CLEAN AND RECONNECT WHENEVER NECESSARY FOR THE PURPOSE OF LOCATING AND REMOVING OBSTRUCTIONS. REPAIR WORK DAMAGED IN THE COURSE OF REMOVING OBSTRUCTIONS.
- THE CONTRACTOR SHALL AT ALL TIMES KEEP THE PREMISES FREE FROM THE ACCUMULATION OF WASTE MATERIAL TO THE SATISFACTION OF THE PROJECT MANAGER, PLACE DUST PROTECTION IN THE FORM OF COVER SHEETS OVER EQUIPMENT AND FURNITURE TO ENSURE NO DUST INFILTRATION. CLEANING TO BE COMPLETED AT THE END OF EACH SHIFT TO THE SATISFACTION OF THE PROJECT MANAGER.

OPERATING AND MAINTENANCE DATA

FURNISH THREE (3) SETS OF OPERATING AND MAINTENANCE DATA FOR ALL NEW EQUIPMENT AND SYSTEMS. DATA SHALL BE ASSEMBLED IN BOOKLET FORM WITH HARD COVER AND INDEX. IDENTIFY FRONT COVER WITH NAME AND LOCATION OF THE PROJECT, CONSULTING ENGINEER AND CONTRACTOR. SUBMIT ONE COPY TO THE ENGINEER FOR APPROVAL.

MATERIALS

MATERIALS AND EQUIPMENT INSTALLED SHALL BE NEW, FULL WEIGHT AND OF BEST QUALITY SPECIFIED. USE SAME BRAND OF MANUFACTURER FOR EACH SPECIFIC APPLICATION. STATICALLY AND DYNAMICALLY BALANCE ROTATING EQUIPMENT FOR MINIMUM VIBRATION AND LOW OPERATING NOISE LEVEL. REPLACE MATERIAL OR WORKMANSHIP BELOW SPECIFIED QUALITY AND RELOCATE WORK WRONGLY PLACED TO THE SATISFACTION OF THE ENGINEER.

THE PRICE SUBMITTED FOR THIS CONTRACT SHALL BE BASED ON THE USE OF MATERIALS AND EQUIPMENT AS SPECIFIED. IF THIS CONTRACTOR WISHES TO QUOTE ON EQUIVALENT MATERIALS AND EQUIPMENT, HE MUST QUOTE ON PRODUCTS APPROVED BY THE ENGINEER, IN WRITING, AS AN EQUIVALENT TO THE PRODUCT SPECIFIED. THIS CONTRACTOR SHALL BE FULLY RESPONSIBLE FOR ANY ADDITIONAL. WORK OR MATERIALS REQUIRED BY ALL OTHER CONTRACTORS TO ACCOMMODATE APPROVED EQUIVALENT MATERIALS OR EQUIPMENT. EXTRAS WILL NOT BE APPROVED TO COVER SUCH WORK.

THE CONTRACTOR IS RESPONSIBLE FOR THIS WORK AND SHALL COORDINATE LOCATIONS FOR ALL HOLES FOR PIPES, DUCTS THROUGH FLOORS AND ROOF ETC. AND PROVIDE SLEEVES REQUIRED TO EXECUTE THE INSTALLATION.

ELECTRICAL SPECIFICATIONS

UTTING AND PATCHING

MINIMUM STANDARDS

- ELECTRICAL INSTALLATION: TO CSA C22.1-LATEST EDITION.
- 2. ONTARIO BUILDING CODE-LATEST EDITION.
- 3. ONTARIO ELECTRICAL SAFETY CODE-LATEST EDITION.

MOUNTING HEIGHTS

- INSTALL ELECTRICAL EQUIPMENT AT FOLLOWING HEIGHTS UNLESS INDICATED OTHER WISE: .1 LOCAL SWITCHES: 1200mm (47")
- .2 WALL RECEPTACLES: .1 GENERAL: 400mm (16")
- .2 ABOVE COUNTERS: 175mm (7")
- .3 SERVICE AREAS & DRIVE THRU: 1200MM (47")
- .3 PANEL BOARDS: 1800mm FROM TOP .4 TELE-COMMUNICATION OUTLETS: 400mm (16")
- .5 OUTDOOR LIGHTING: AS SHOWN ON THE DRAWINGS. IDENTIFICATION IDENTIFY WITH LAMACOID NAMEPLATES ALL ELECTRICAL EQUIPMENT SHOWN ON THE DRAWINGS AND/OR MENTIONED IN THE SPECIFICATION SUCH AS MOTORS, SWITCHES, STARTERS, PANEL BOARDS,
- TRANSFORMERS, CONTROLS, AND SPECIAL RECEPTACLES, REGARDLESS OF WHETHER OR NOT THE ELECTRICAL EQUIPMENT WAS FURNISHED UNDER THIS SECTION OF THE SPECIFICATION. IDENTIFICATION REVIEWED BY ENGINEER. UNLESS OTHERWISE SPECIFIED, NAMEPLATES SHALL BE RIGID LAMACOID, MINIMUM 1.5mm THICK WITH
- BLACK LETTERS ENGRAVED ON A WHITE BACKGROUND. NAMEPLATES TO BE NEATLY PLACED, AND SQUARE TO SURROUNDING BUILDING OR EQUIPMENT LINES, AND FASTENED IN PLACE WITH MECHANICAL FASTENERS (SCREWS OR POP RIVETS) AS REVIEWED BY ENGINEER.
- PROVIDE NEATLY TYPED UPDATED CIRCUIT DIRECTORIES IN A PLASTIC HOLDER ON THE INSIDE DOOR OF NEW PANEL BOARDS, WITH COPY IN MANUAL.
- IDENTIFY ALL PULL AND JUNCTION BOXES, WITH PERMANENT DYMO MARKER IDENTIFICATION INDICATING SQUARE PANEL AND CIRCUIT NUMBERS.

LOCATION OF OUTLETS

- LOCATE OUTLETS AS SHOWN ON DRAWINGS.
- DO NOT INSTALL OUTLETS BACK-TO-BACK IN WALL; ALLOW MINIMUM 150mm (6") HORIZONTAL CLEARANCE BETWEEN BOXES, AND LOCATE IN SEPARATE STUD CAVITIES WHENEVER POSSIBLE.
- CHANGE LOCATION OF OUTLETS AT NO EXTRA COST OR CREDIT, PROVIDING DISTANCE DOES NOT EXCEED 3 METERS AND INFORMATION IS GIVEN BEFORE INSTALLATION.

BOND TO SERVICE MAIN WATER PIPE WITH CONNECTION AS REQUIRED. GROUND ALL EQUIPMENT WITH APPROVED FITTINGS AND GROUND CONDUCTORS OF AMPLE AMPACITY AS REQUIRED BY THE O.H.E.S. CODE. ALL GROUND CONDUCTORS SHALL HAVE GREEN INSULATION.

- 600V RW90 RATING, COPPER CONDUCTORS, MINIMUM #12 AWG, EXCEPT AS OTHERWISE NOTED. 15A, 120V RECEPTACLE BRANCH CIRCUIT HOME RUNS SHALL BE MINIMUM #12 AWG.
- ENSURE VOLTAGE DROP DOES NOT EXCEED 3%. MEGGER ALL BRANCH CIRCUIT WIRING TO MEET CODE
- WIRE CONNECTORS: TWIST-ON PRESSURE TYPE FOR #10 AND SMALLER. SPLIT-BOLT TYPE FOR #6 AND LARGER. 2 BOLT, PRESSURE TYPE SPADE LUGS FOR CONNECTIONS TO BUS. PROVIDE ALL CONDUIT, WIRING, BOXES, SWITCHES, OUTLETS, DEVICES, ETC., AND ALL NECESSARY

ARCHITECTURAL CONSTRUCTION.

GALVANIZED SHEET STEEL BOXES WITH CONDUIT K.O. TO SUIT INSTALLATION. MASONRY FOR BLOCK WALLS, CONCRETE TIGHT FOR CONCRETE ENCASEMENT, TYPE FS FOR SURFACE MOUNTING. JUNCTION AND PULL BOXES C/W SCREW-ON FLAT COVERS. PROVIDE PERMANENT MARKING OF SYSTEM OR CIRCUIT

HANGERS, INSERTS AND SUPPORTS OF APPROVED TYPES AS REQUIRED TO SUIT INSTALLATION AND

NUMBERS TO THE COVER PLATE OF ALL JUNCTION AND PULL BOXES. TYPE D BOXES: SURFACE MOUNTING, 16 GAUGE, ELECTRO-GALVANIZED STEEL UTILITY BOXES WITH

RECEPTACLES: COMMERCIAL GRADE, 15A 120V (5-15R) UNLESS OTHERWISE NOTED OTHER

SCREW-ON COVER. FINISH: ASA-61 GREY ENAMEL SIZE AS INDICATED.

SWITCHES: COMMERCIAL GRADE, 15A OR 20A, SUITABLE FOR SIDE WIRING, WHITE IN COLOUR, MOUNTING HEIGHT 1200 (48") AFF UNLESS STATED OTHERWISE. ACCEPTABLE MATERIALS: HUBBELL

CONFIGURATIONS NOTED. MOUNTING HEIGHT 350 (14") AFF UNLESS STATED OTHERWISE OR AS SHOWN ON

- INTERIOR DESIGN DRAWINGS. WHITE IN COLOUR. ACCEPTABLE MATERIALS: HUBBELL #CBR151.
- COVER PLATES: WHITE

4. TYPE-WRITTEN PANEL DIRECTORY

- DISCONNECT SWITCHES
- FUSIBLE AND NON-FUSIBLE HEAVY DUTY DISCONNECT SWITCHES IN CSA ENCLOSURE, SIZE AS INDICATED.
- PROVISION FOR PADLOCKING IN ON-OFF SWITCH POSITION BY THREE LOCKS. MECHANICALLY INTERLOCKED DOOR TO PREVENT OPENING WHEN HANDLE IN ON POSITION.
- FUSES: SIZE AS INDICATED.
- . QUICK-MAKE, QUICK-BREAK ACTION.
- INDICATE NAME OF LOAD CONTROLLED ON SIZE 4 NAMEPLATE.

PANEL BOARDS AND BREAKERS

- PRODUCT OF ONE MANUFACTURER.
- COPPER BUS AND BREAKERS RATED FOR 10,000A (SYMMETRICAL) INTERRUPTING CAPACITY.
- MAINS, NUMBER OF CIRCUITS AND NUMBER & SIZE OF BRANCH CIRCUITS AS INDICATED ON DRAWINGS. BOLT-ON MOULDED CASE CIRCUIT BREAKERS QUICK MAKE, QUICK BREAK TYPE FOR MANUAL AND

AUTOMATIC OPERATION WITH TEMPERATURE COMPENSATION FOR 40°C AMBIENT.

	LIGHTING FIXTURE SCHEDULE							
TYPE	DESCRIPTION	CAT. NO.	LAMP	VOLTAGE				
А	2 'x 2' LED FLAT PANEL, T-BAR CEILING	LITHONIA LIGHTING EPANL 22 34L 35K, 190887602647	31.3 W 3500 K	120				
В	HIGH BAY LED	LITHONIA LIGHTING IBG 24000LM SEF AFL GND	150 W 4000 K	120				
С	6" RECESSED LED DOWNLIGHT	LITHONIA LIGHTING - GOTHAM EVO 35 30 MD	36.6 W 3500 K	120				
D	NOT USED			120				
Е	LED, WALL MOUNTED FORWARD THROW MEDIUM OPTICS	DSXW2 LED 30C 700 40K TFTM, 30 @ 700 mA	8082 LM 4000 K	120				
F	NOT USED							
G	EXTERIOR WALL MOUNT ABOVE DOOR LOW-PROFILE, LED	LITHONIA LIGHTING	20 W 4000 K	120				

LITHONIA LIGHTING

68 W

4000 K

120

CO and NO2 monitor — Gasoline and diesel exhaust monitoring

Dual channel gas monitoring system with integral carbon monoxide and nitrogen dioxide electrochemical sensors.

Monitor enclosed in 16 gauge steel, ANSI/ASA 61 grey Dual alarm trip points: Carbon monoxide at 25 and 100 PPM

EXTERIOR UP/DOWN - NARROW, LED

- Nitrogen dioxide at one and three PPM Common low and high DPDT, 10A alarm relays, for control of ventilation equipment and/or
- auxiliary alarm LEDs for power on, low, high and fail

Test sequence activated by push button

- Alarms equipped with user selectable time delays, whereby, when chosen, low and high alarm conditions must prevail for five and ten minutes, respectively, before activation occurs. Alarms equipped with dead band, which requires gas levels to decline slightly below the original trip point before
- alarms will automatically reset. CSA certified Two year warranty

ARBON MONOXIDE SENSOR


- Range of 0-100 PPM CO Electrochernical type sensor Three year warranty
- IITROGEN DIOXIDE SENSOR
- 4-20 mA linear signal output corresponding to 0-10 PPM NO2

TOTAL LOAD

CHARGE TOTALE


Electrochemical type s	>
One year warranty	

			PANNEAU		A			TYPE	
PHASE LOCATION-EMPL			ACEMENT		STOCK RM		1	MAINS-CONDUITE 400 AMPS.	
WIRE-COND FED FROM-D								ENTER AT-ENTREÉ MTG-INST	
WINZ 00113.									
	C	CIR	BKR.	, D	_	BKR.			
	1	NO	DISJ	АВ	C	DISJ.	NO	DESIGNATION	
FURNACE, F1		1	15	•	+	15	2	RECEPTACLES	
FURNACE, F2			15	+	•	15	4	TV RECEPTACLES	
HRV		5	15	•	+	15	6	RECEPTACLES	
HWT		7	15	_	•	15	8	DOOR OPENER	
CU-1		9	115	•	+	15	10	SPARE	
		11	1	\perp		15	12	RECEPTACLES	
CU-2		13	115		\perp	30 1	14		
		15		1			16		
GHU-1 & 2		17	15		Ţ	15	18	DEDICATED RECEPTACLES	
GHU-3 & 4		19	15			15	20	TV RECEPTACLES	
SPARE		21	15		Ĭ	15	22	RECEPTACLES	
EF-1		23	15	<u> </u>		15	24	DEDICATED RECEPTACLES	
SPARE		25	15		Ĭ	15	26		
CEILING FANS - SHOP		27	15				28		
EMERG. LGHT, EXITS	I			T	T	15		RECEPTACLES	
			15	•	T	20	30	OF FBREZURER, REGEL TROLE 71 Ex	
SHOP LIGHTS		31	15		9	15	32	FRIDGE	
SHOP LIGHTS		33	15	•	$^{+}$	20	34	MICROWAVE	
SPARE		35	15	+	•	20	36	MICROWAVE	
EXTERIOR LIGHTS		37	15	•	+	15	38	112021 1710220	
EXTERIOR LIGHTS		39	15	+	•	15	40	RECEPTACLES	
SHOP RECEPTACLES		41	20	•	+	15	42	DEDICATED RECEPTACLES	
SHOP RECEPTACLES		43	20	+	•	15	44	DEDICATED RECEPTACLES	
SHOP RECEPTACLES		45	20	•	+	15	46	SPARE	
SHOP RECEPTACLES		47	20	+	•	15	48	BUILDING SIGN	
SHOP RECEPTACLES		49	20	•	+	15	50	SPARE	
WELDING STATION		51	150	+	•	15	52	OFFICE LIGHT GROUND FLOOR	
		53		•	+	15	54	SPARE	
WELDING STATION		55	150	+	•	15	56	OFFICE LIGHT GROUND FLOOR	
		57		•	+	15	58	SPARE	
O/H DOOR		59	115	\perp	•	15	60	SPARE	
		61		_	4	15	62	O/H DOOR	
O/H DOOR		63	115	1			64		
		65			I	15 j	-	O/H DOOR	
O/H DOOR		67	115			'	68	52001.	
C,T DOOR		69	'			15	70	O/H DOOR	
COMPRESSOR		71	<u>'</u> 			'3	72		
COMI INLOGUIN		73	+		Ĭ	20	74	WELL PUMP	
PRESSURE WASHER		75					76		
FNEODURE WASHER		77				15		SPARE WATER SOFTNER	
			ı			15	78	WATER SOFTNER	
		79 81		•	_	100	80	PANEL 'B'	
Ø "A" TOTAL:		. .		1	'	• •			
Ø "A" TOTAL:									
Ø "A" TOTAL:									

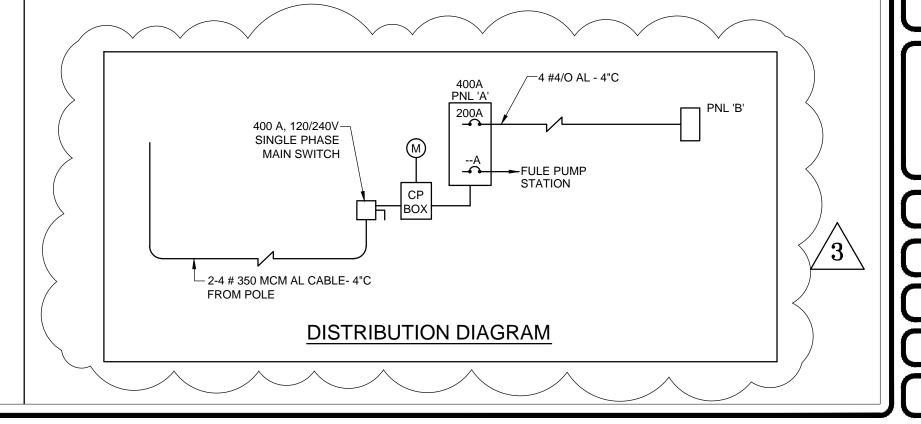


FEEDER-AETÈRE



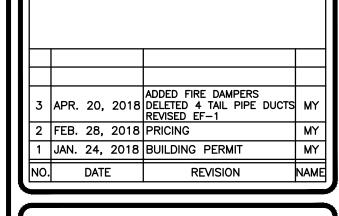



THIS DRAWING IS THE SOLE PROPERTY OF M & E ENGINEERING. REPRODUCTION IS NOT PERMITTED

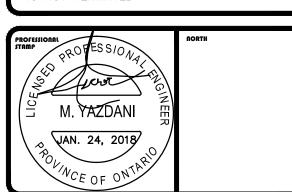

2688 CARP ROD, OTTAWA, ON **ELECTRICAL**

BRY-AIN HOLDINGS LTD.

EQUIPMENT REPAIR GARAGE